


4600 Park Road | 1st Floor - Suite 109

As Built

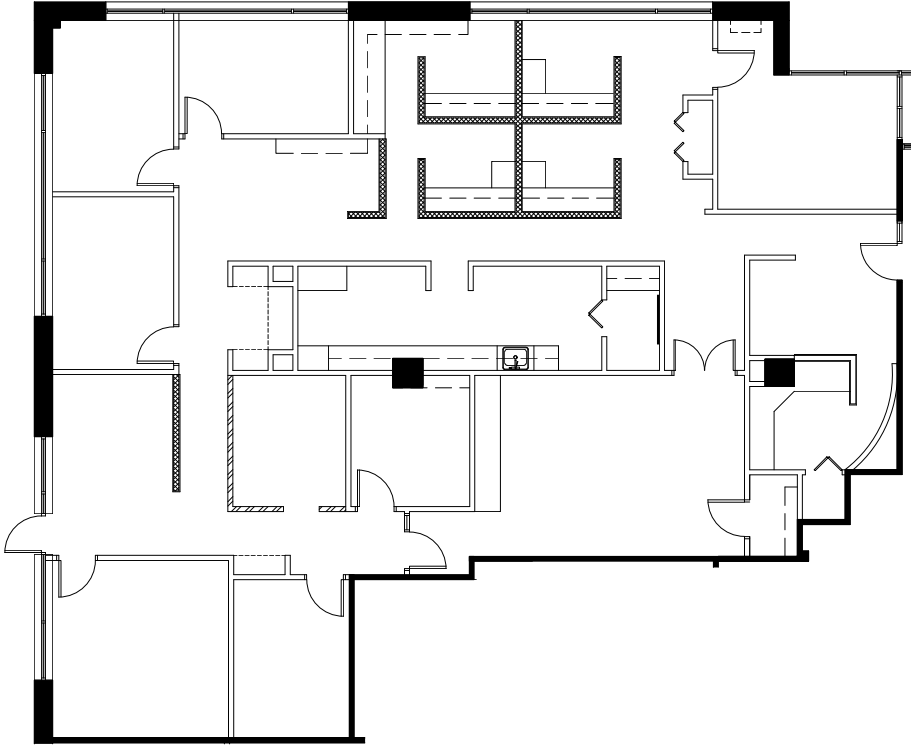

← PARK ROAD →

AVAILABLE ± 3,925 RSF