


4600 Park Road | 2nd Floor - Suite 220 & 230

As Built

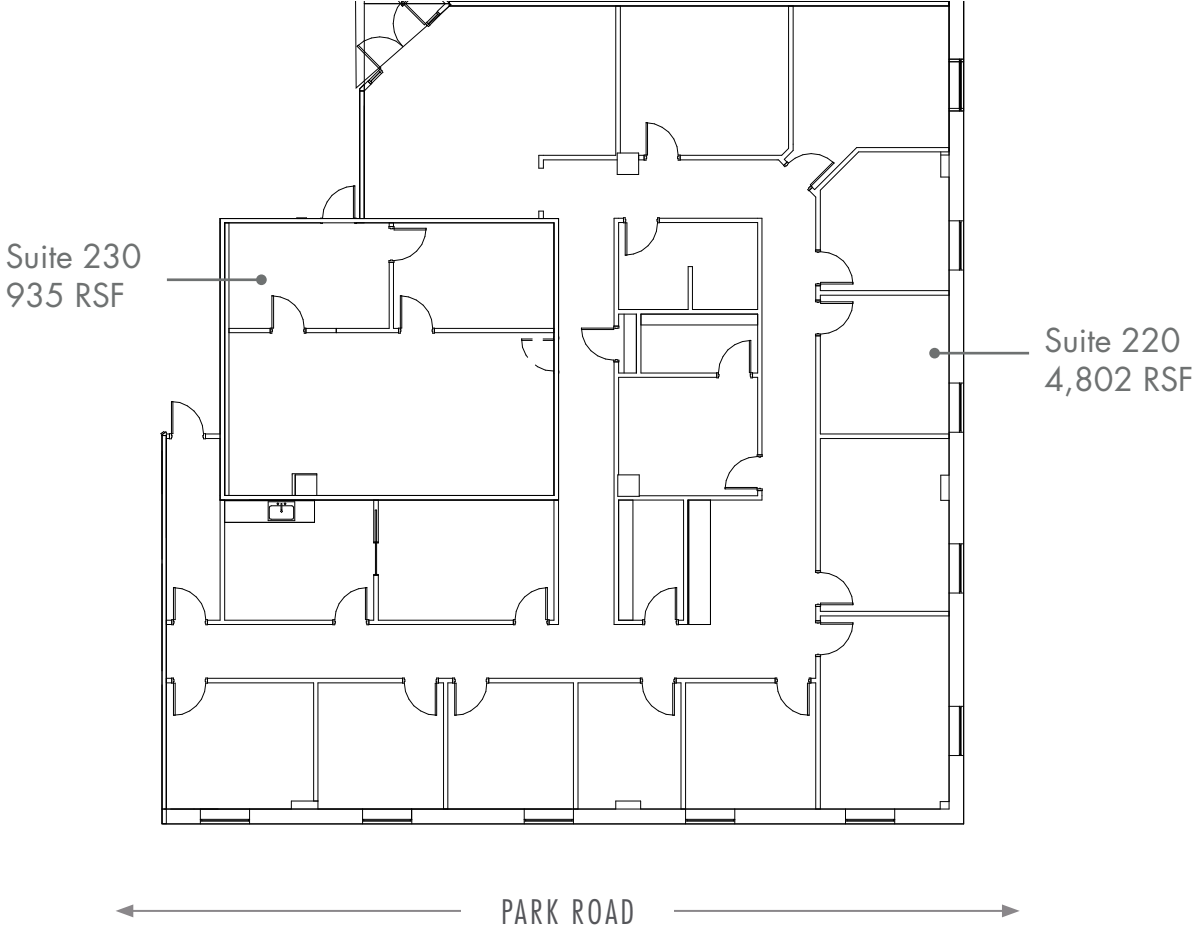

AVAILABLE ± 935 - 5,737 RSF