


4600 Park Road | 3rd Floor - Suite 300

As Built

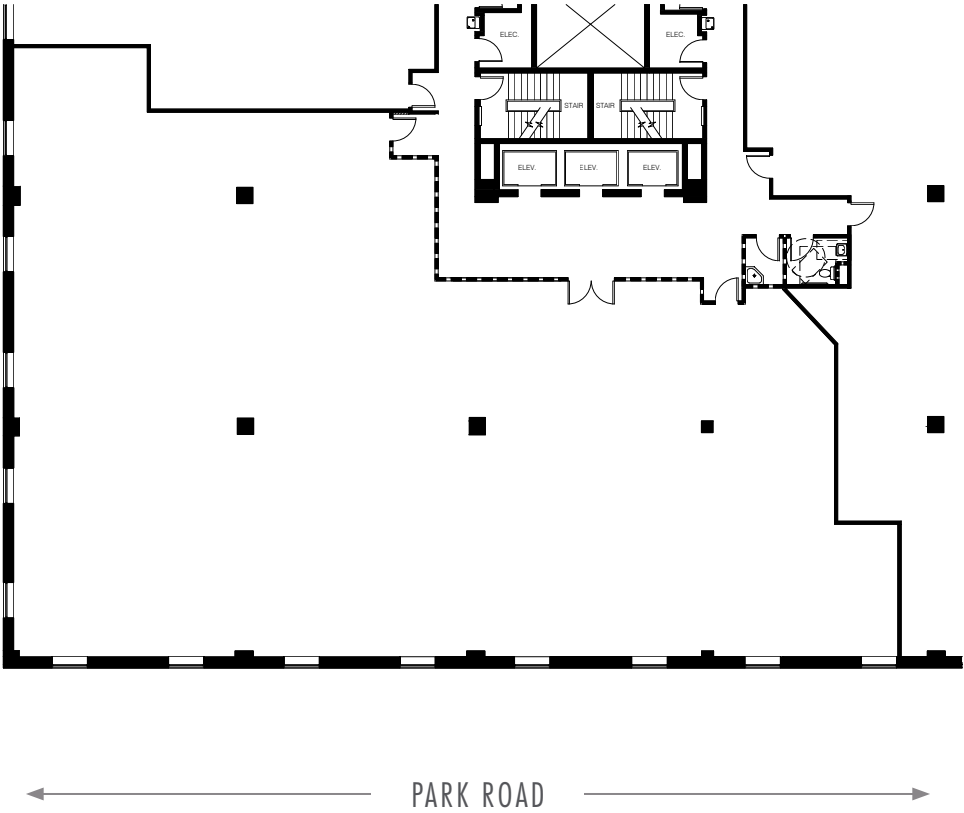

AVAILABLE ± 7,822 RSF