


4600 Park Road | 2nd Floor - Suite 200

As Built

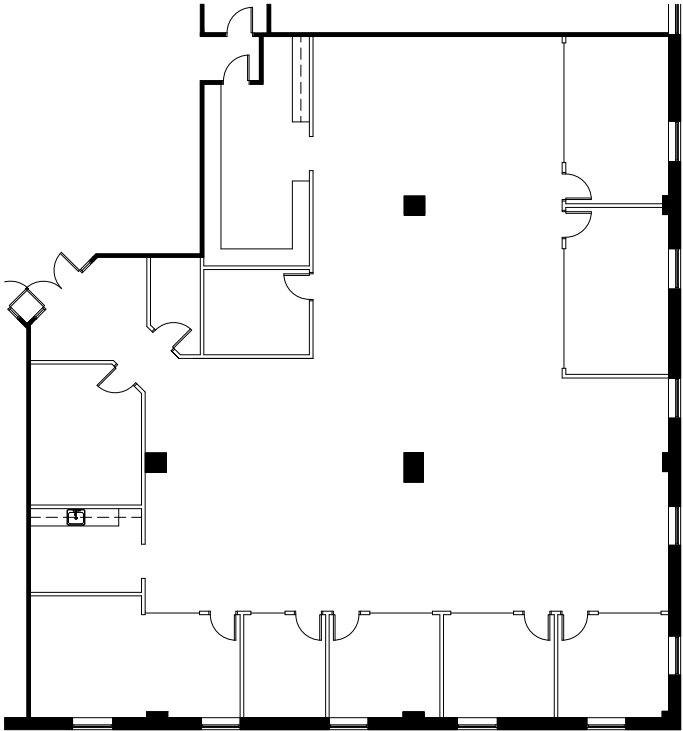

AVAILABLE ± 6,329 RSF