


4600 Park Road | 2nd Floor - Suite 220

As Built

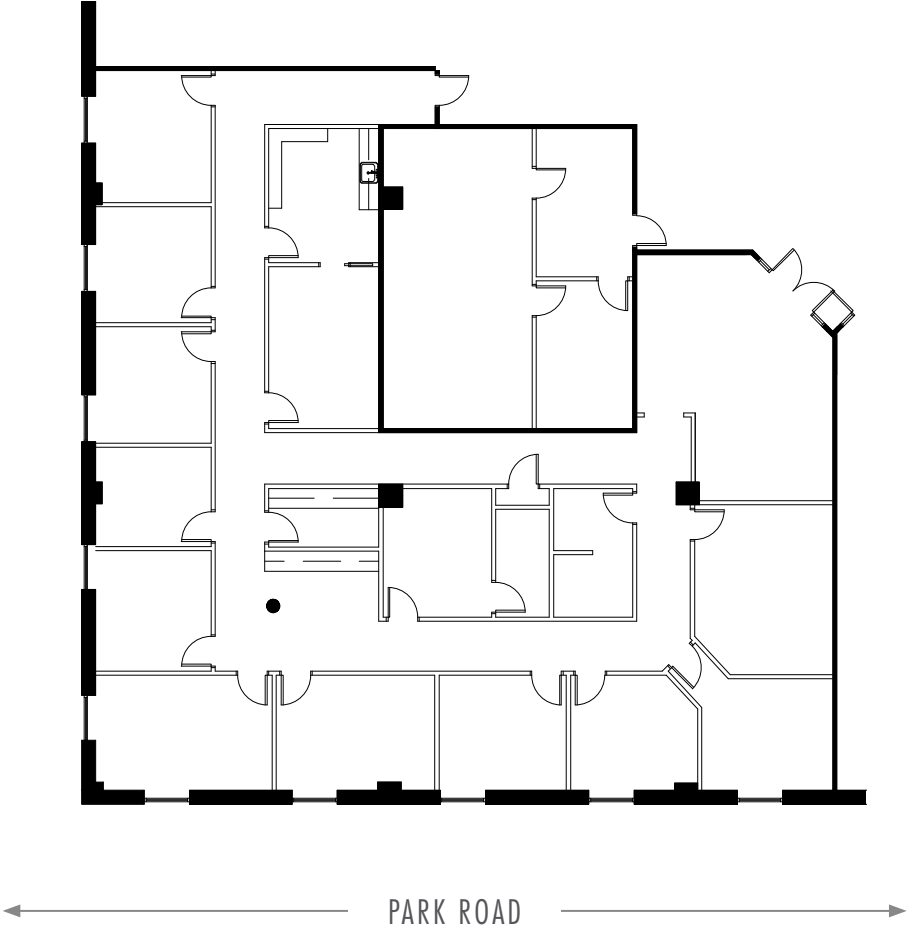

AVAILABLE ± 5,923 RSF