


4600 Park Road | 2nd Floor - Suite 275

As Built

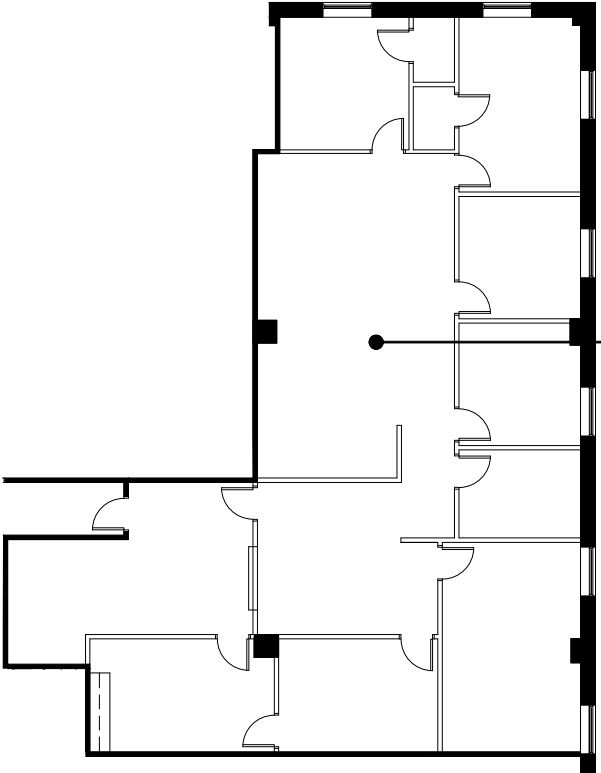

AVAILABLE ± 3,142 RSF