


4600 Park Road | 3rd Floor - Suite 300

As Built

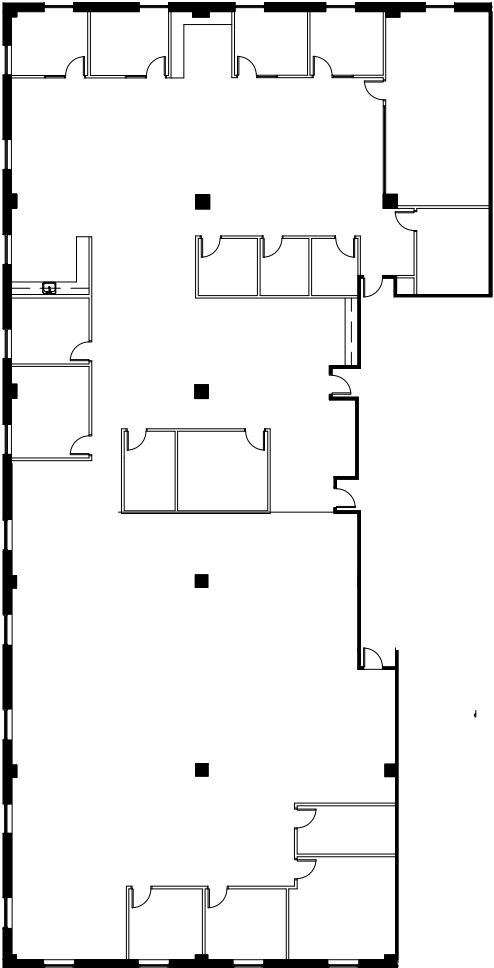

AVAILABLE ± 10,744 RSF