


4600 Park Road | 3rd Floor - Suite 390

As Built

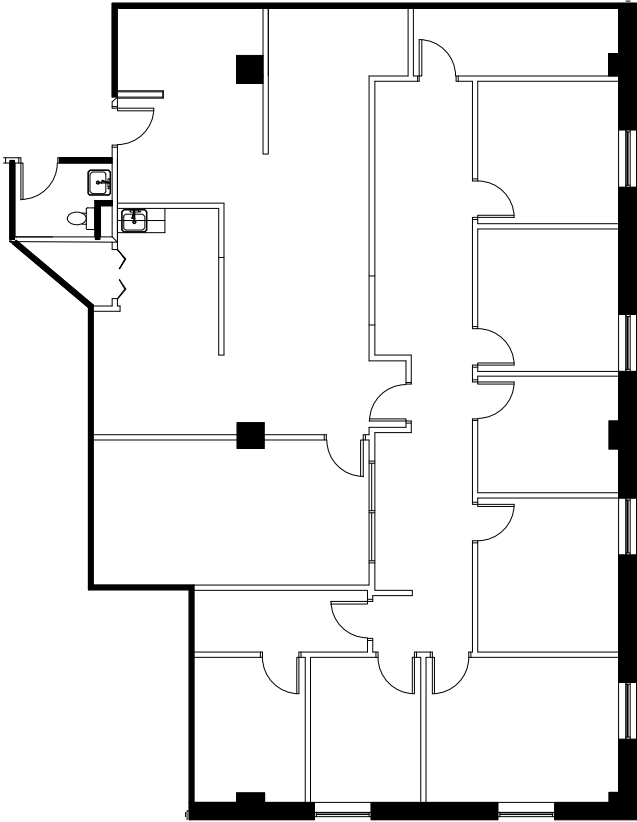

AVAILABLE ± 2,940 RSF