


4600 Park Road | 4th Floor - Suite 400

As Built

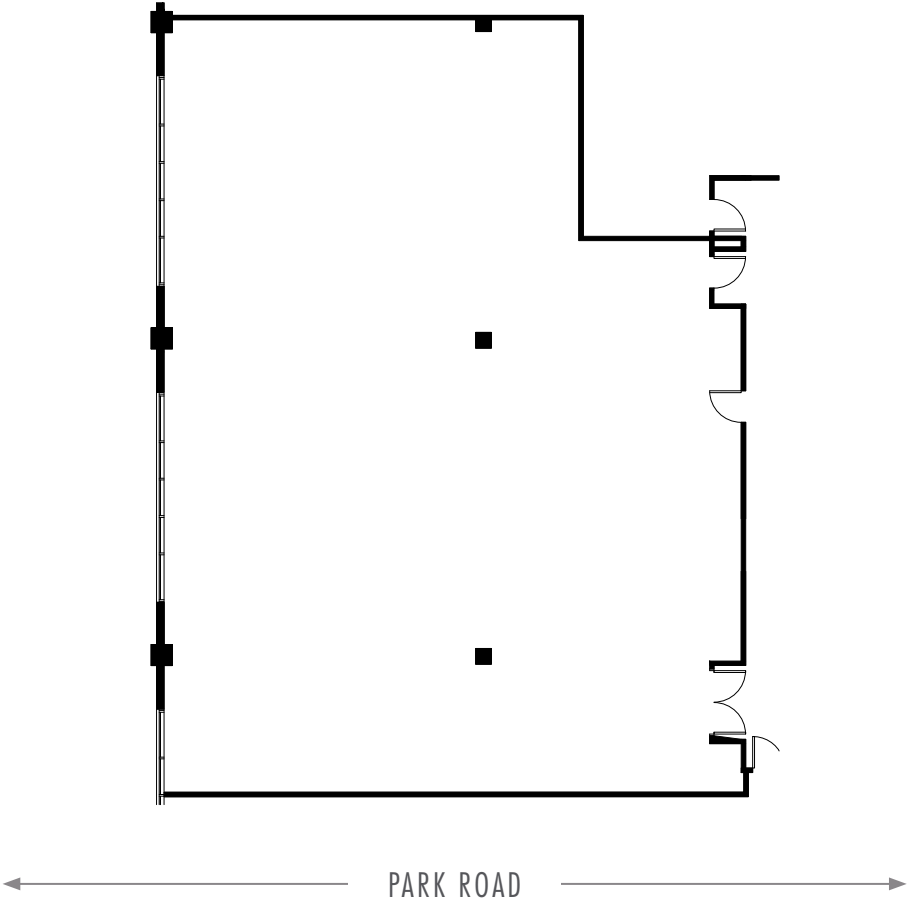

AVAILABLE ± 4,442 RSF