


4600 Park Road | 4th Floor - Suite 450

As Built

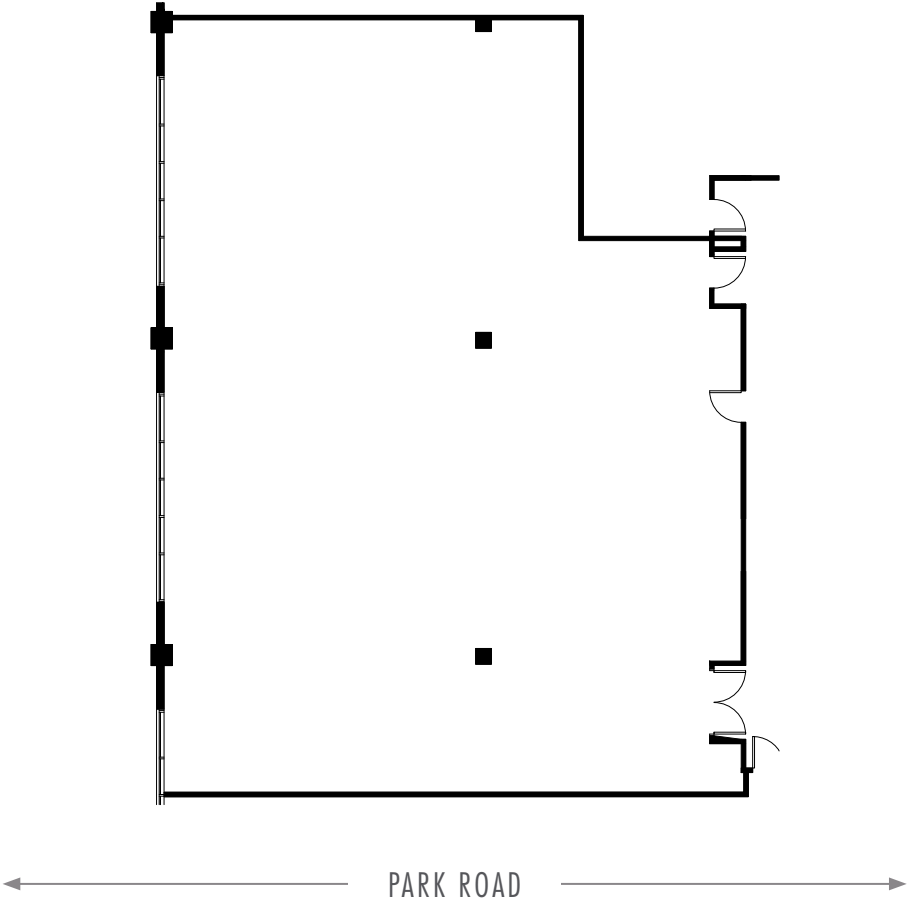

AVAILABLE ± 4,442 RSF